


# SPACE AVAILABILITY

SUITE 60 | 4,594 RSF



10050 CONSTELLATION BLVD  
FREESTANDING BUILDING SPACE

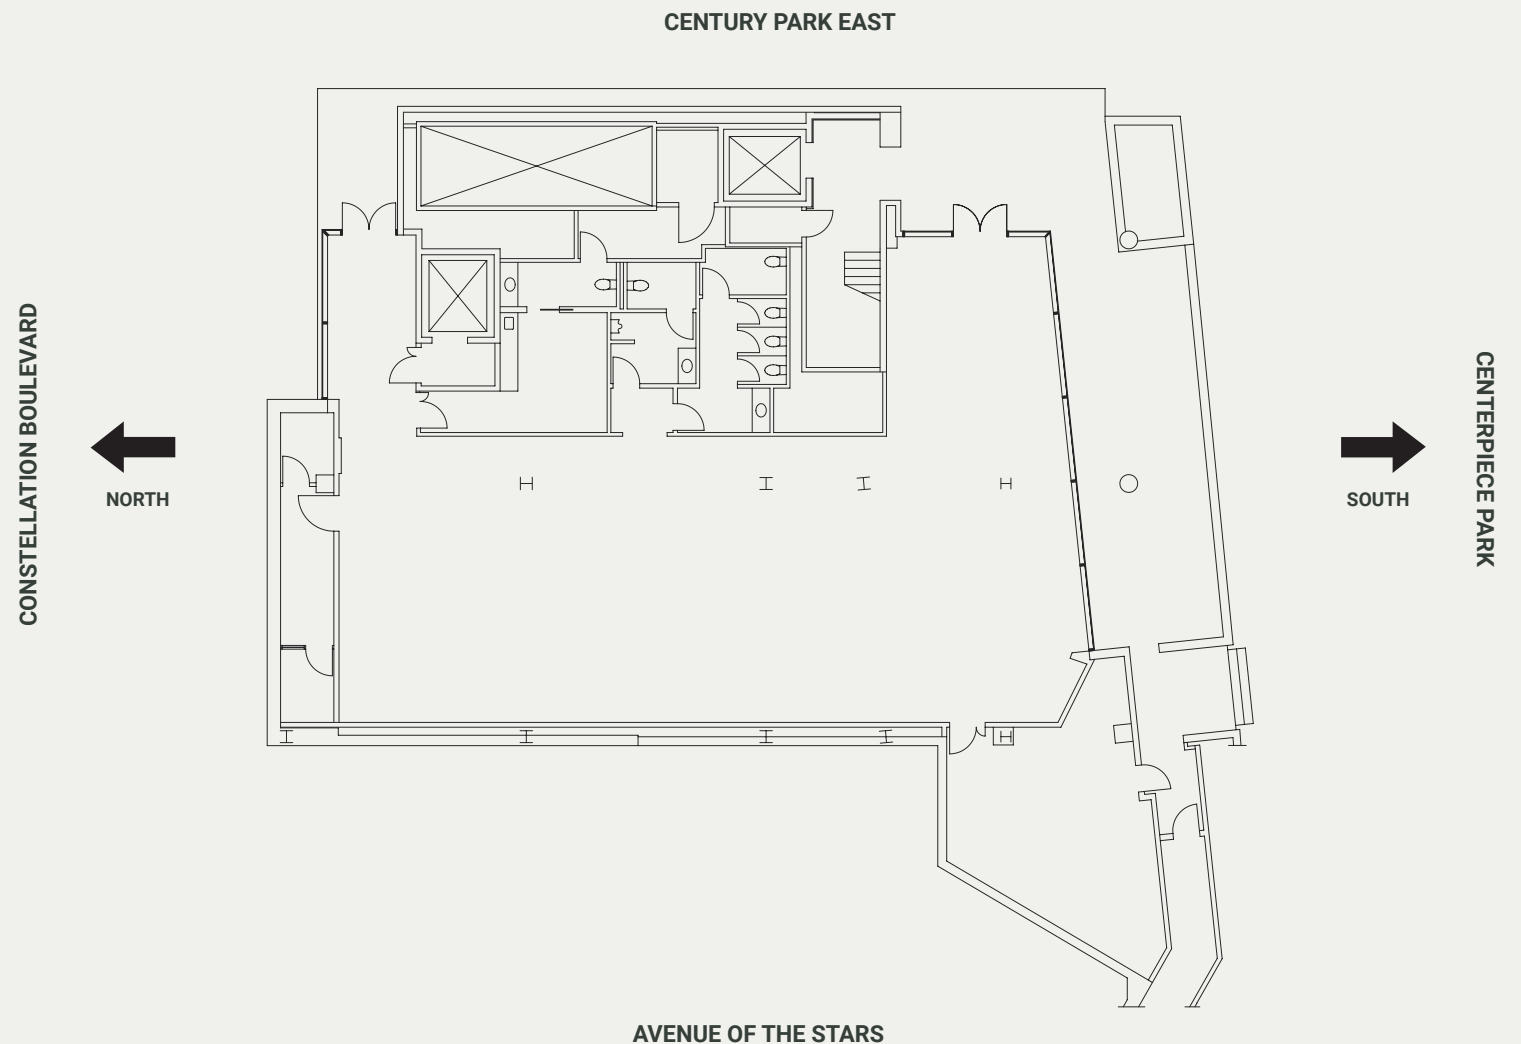